


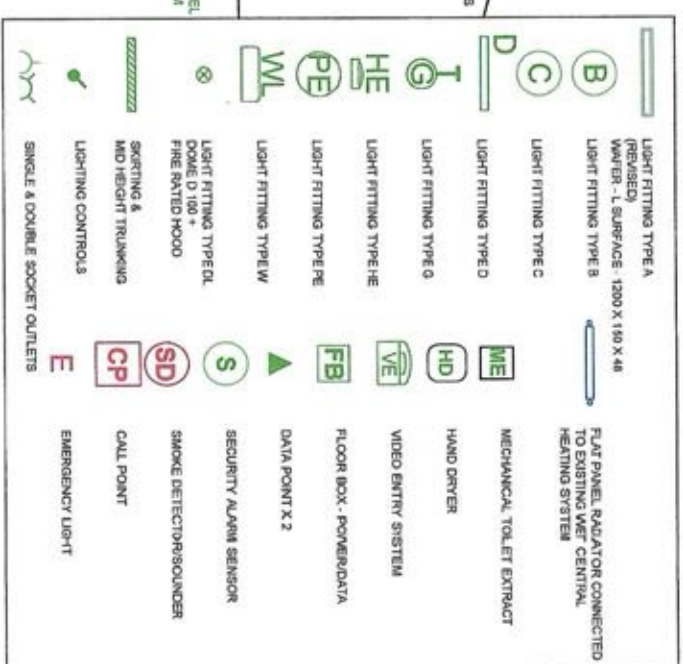

Second Floor T 020 1494 3632
25A, Cannon Street F 020 1494 3553
London WC1E 7QZ
info@pne-cv.com
www.pne-cv.com

The Pharmacy, Dupont Rd T 01749 34 66 96
Buckton Road F 01749 34 66 77
Barnsley S44 5JG
www.pne-cv.com

Project:	THE BAKERY 4A FLEET ROAD LONDON NW3 2QS
Title:	AS BUILT GROUND FLOOR PLAN - M & E

Date:	26.11.2024
Scale:	1:500/A2
Drawn:	
No.	678.01/AB01

 LIGHT FITTING TYPE A (GREEN) WATER - 1200 X 100 X 48 LIGHT FITTING TYPE B	 LIGHT FITTING TYPE C	 LIGHT FITTING TYPE D	 LIGHT FITTING TYPE G	 LIGHT FITTING TYPE HE	 LIGHT FITTING TYPE PE	 LIGHT FITTING TYPE W	 LIGHT FITTING TYPE DL DOWN D 100 + FIRE RATED HOOD	 SIGHTING & MID HEIGHT TRUNKING	 LIGHTING CONTROLS
 MECHANICAL TOILET EXTRACT	 HAND DRYER	 VIDEO ENTRY SYSTEM	 FLOOR BOX - POWER/DATA	 DATA POINT X2	 SECURITY ALARM SENSOR	 SMOKE DETECTOR/SOUNDER	 CALL POINT	 EMERGENCY LIGHT	 SINGLE & DOUBLE SOCKET OUTLETS

[illegible]

Second Floor
264, Darton Street
London W1P 7DZ
tbiology@cardiac.co.uk

T 020 7464 2622
F 020 7464 2533

The Ferry, Dargate Rd
Dragon Market
Formby, Merseyside
L21 9JF
www.ferry-medicine.co.uk

Date:	20.11.2024
Student:	1702/A2
Drawn:	
No.	678.01/AB02



 LIGHT FITTING TYPE A (RECESSED) W/INTER - L SURFACE - 1200 X 150 X 40 LIGHT FITTING TYPE B	 FLAT PANEL RADIATOR CONNECTED TO EXISTING WET CENTRAL HEATING SYSTEM
 LIGHT FITTING TYPE C	 MECHANICAL TOILET EXTRACT
 LIGHT FITTING TYPE D	 HAND DRYER
 LIGHT FITTING TYPE E	 VIDEO ENTRY SYSTEM
 LIGHT FITTING TYPE F	 FLOOR BOX - POWER/DATA
 LIGHT FITTING TYPE G	 DATA POINT X 2
 LIGHT FITTING TYPE H	 SECURITY ALARM SENSOR
 LIGHT FITTING TYPE I DOWN D 100 + FIRE RATED HOOD	 SMOKE DETECTOR/SOUNDER
 SPORTING & MID HEIGHT TRUNKING	 CALL POINT
 LIGHTING CONTROLS	 EMERGENCY LIGHT
 SINGLE & DOUBLE SOCKET OUTLETS	

Flow Description	Date	Initial

Architect and structural engineer

Second floor T 020 7494 3032
35A Dawson Street F 020 7494 3033
London W1P 0JZ
bl@pierre-martin.co.uk

The Henry, Dryden Rd T 01749 34 00
Empire Market F 01749 34 00
Gerrards Hill St
www.pierre-martin.co.uk

Client:

Project: THE BAKERY
4A FLEET ROAD
LONDON NW3 2QS

Title: **AS BUILT MEZZANIE
PLAN (2ND FLOOR) - M & E**

Date:	26.11.2004
Sheet:	150/042
Drawn:	
No.	678.01/AB03